

RECORD DRAWINGS  
**PAVEMENT AND DRAINAGE IMPROVEMENTS**  
 FOR  
**ECKEL TRACE PLATS 3, 4 & 5**  
 PERRYSBURG TOWNSHIP, WOOD COUNTY, OHIO

STANDARD DRAWINGS

ODOT

RM-1.1 MONUMENT ASSEMBLY	7/18/14
MH-1.2 MANHOLE NO. 3	1/18/13
DM-4.4 CONSTRUCTION EROSION CONTROLS	7/20/12
CB-1.1 CATCH BASIN 2-2B	1/18/13
HW-2.1 HALF-HEIGHT HEADWALLS	1/18/13
HW-2.2 HALF-HEIGHT HEADWALLS	1/18/13

WOOD COUNTY

TYPE "B" MONUMENT ASSEMBLY
TYPE "B" TURNAROUND W/BARRICADE

INDEX OF SHEETS

Title Sheet	1
General Notes	2
General Summary	3
Typical Section and Details	4
Storm Water Pollution Prevention Plan (SWP3)	5-8
Site Grading Plan	9-10
Plan and Profiles	11-13
Cross Sections	14-23
Intersection Details & Signage	24-25

BENCHMARK DATA

Site Bench Mark


North Bonnet on Fire Hydrant North side of Bay Trace Drive,  
 Station 8+44.82, 246.15' Lt., Elevation..... 644.03

Site Bench Mark

North Bonnet Bolt on Fire Hydrant South side of Bay Trace Drive,  
 Station 12+15.35, 17.27' Rt., Elevation..... 643.03

CONVENTIONAL SIGNS

Centerline	---
Existing Pavement	----
Existing Utilities	.....
Fence Line	---x---
Power Pole	.....
Telephone Pole	.....
RM-1.1 Monument Assembly	.....
Wood County Type A Monument Assembly	.....
Storm Manhole	.....
Catch Basin	.....
Yard Drain	.....
Sanitary Manhole	.....
Existing Storm Sewer	.....
Proposed Storm Sewer	.....

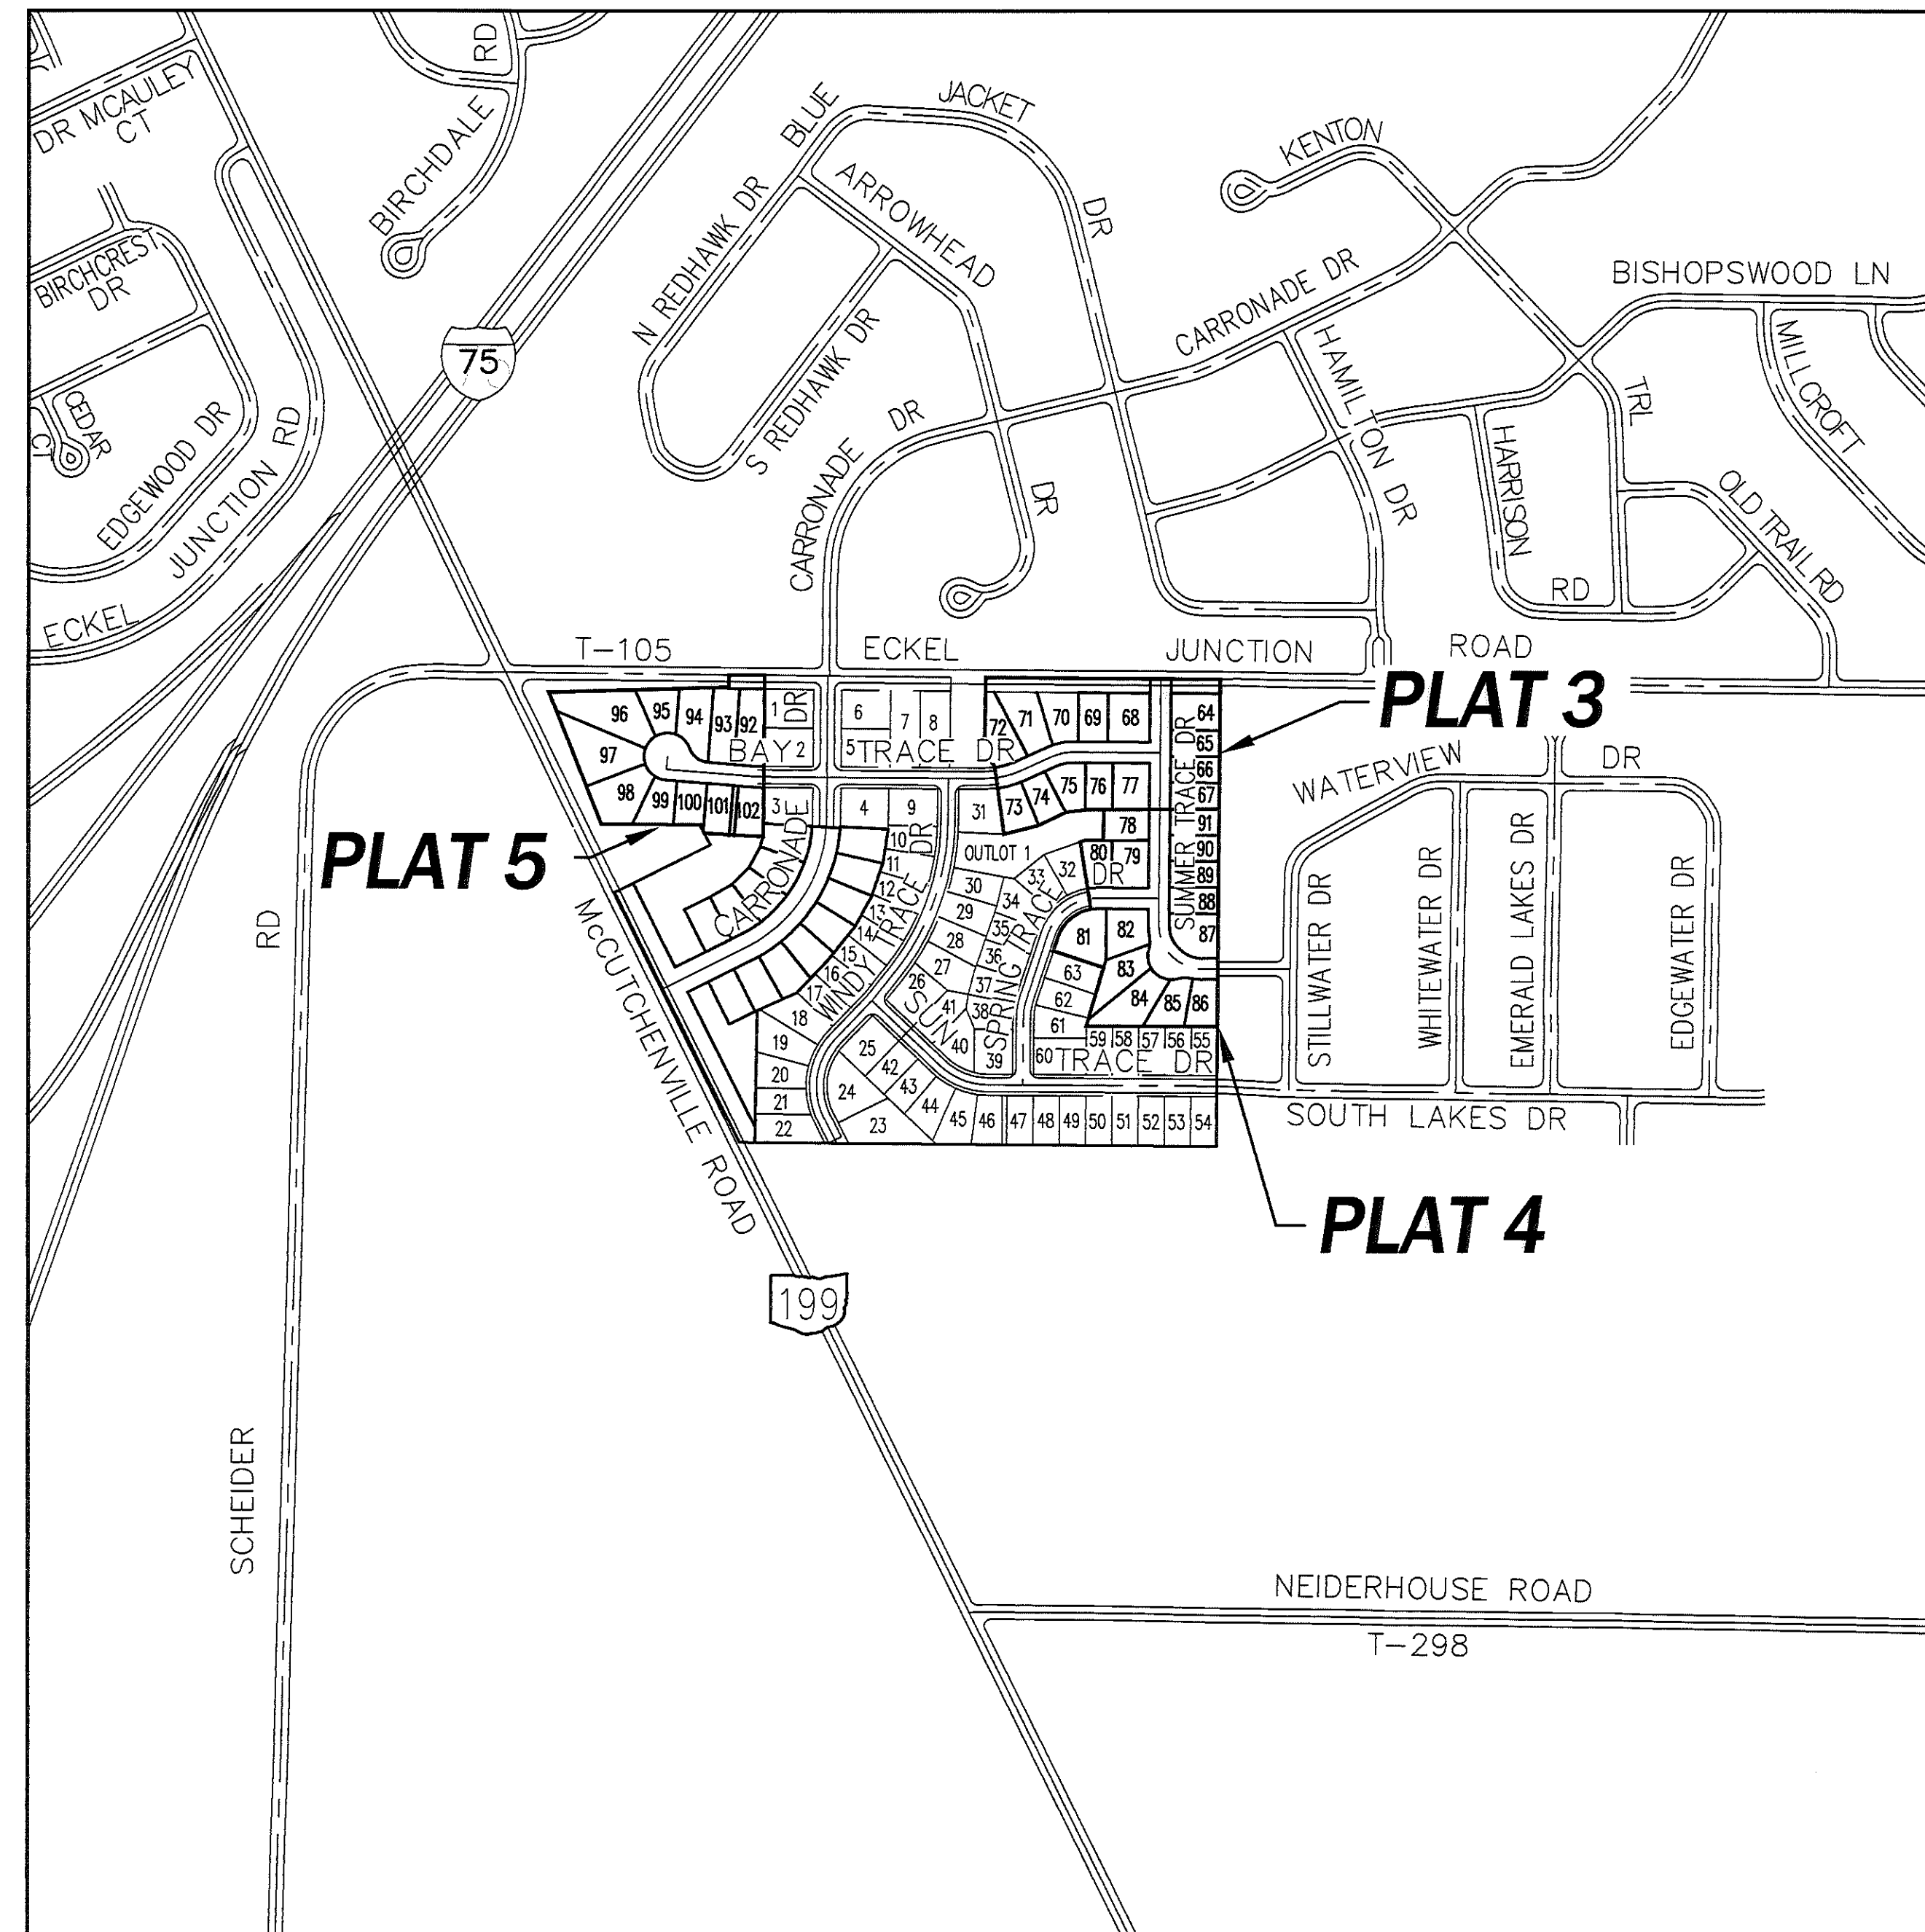

LOCATION MAP  
 1"=400'

SCALES

Site Grading Plan	1"=50'
Plan	1"=40'
Profile, Horizontal	1"=40'
Profile, Vertical	1"=5'
Cross-Sections, Horizontal	1"=20'
Cross-Sections, Vertical	1"=5'

APPROVED BY:

*David R. Fisher* 7/19/15  
 PERRYSBURG TOWNSHIP ENGINEER DATE

APPROVED BY:

*Raymond A. Huber* 8/24/15  
 RAYMOND A. HUBER, PE, PS DATE

THE ABOVE SIGNATURE CONSTITUTES APPROVAL OF THOSE ITEMS OUTLINED  
 IN THE WOOD COUNTY CONSTRUCTION STANDARDS OR AS AMENDED BY  
 THE WOOD COUNTY ENGINEER. ALL TECHNICAL DETAILS REMAIN THE  
 RESPONSIBILITY OF THE ENGINEER PREPARING THE PLANS.

SIGNATURE VALID FOR 18 MONTHS FROM DATE OF SIGNING.

DEVELOPED BY:


ECKEL TRACE DEVELOPMENT, LTD.  
 3150 REPUBLIC BLVD. NORTH  
 SUITE 3  
 TOLEDO, OHIO 43615

*Stephen R. Mitchell* 7/1/15  
 STEPHEN R. MITCHELL DATE

PREPARED BY:

**ESA**  
**Engineers, Surveyors & Associates, LLC**  
 5353 Secor Road, Toledo, Ohio, 43623  
 Phone: (419) 475-9445, Fax: (419) 475-9473

*Gregory L. Boudouris* 7-1-2015  
 GREGORY L. BOUDOURIS, P.E., P.S. DATE

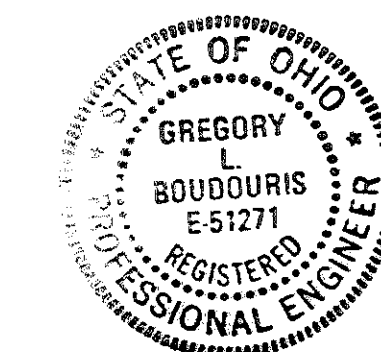

UNDERGROUND UTILITIES  
 TWO WORKING DAYS  
**BEFORE YOU DIG**  
 Call 800-362-2764 (Toll Free)  
 OHIO UTILITIES PROTECTION SERVICE  
 NON-MEMBERS  
 MUST BE CALLED DIRECTLY



Know what's below.  
 Call before you dig.

DRAWING OF RECORD DECEMBER 2015