WALDO J. AMMON DITCH #2407
WOOD COUNTY CENTER-PORTAGE TOWNSHIPS
DONALD R. McNEELEY COUNTY ENGINEER

OLD DITCH #1168

DRAINAGE AREA **DITCH BOOK #** 156

OCTOBER, 1975

DRAWN BY C. AMEND

SCALE 1" = 660'

N
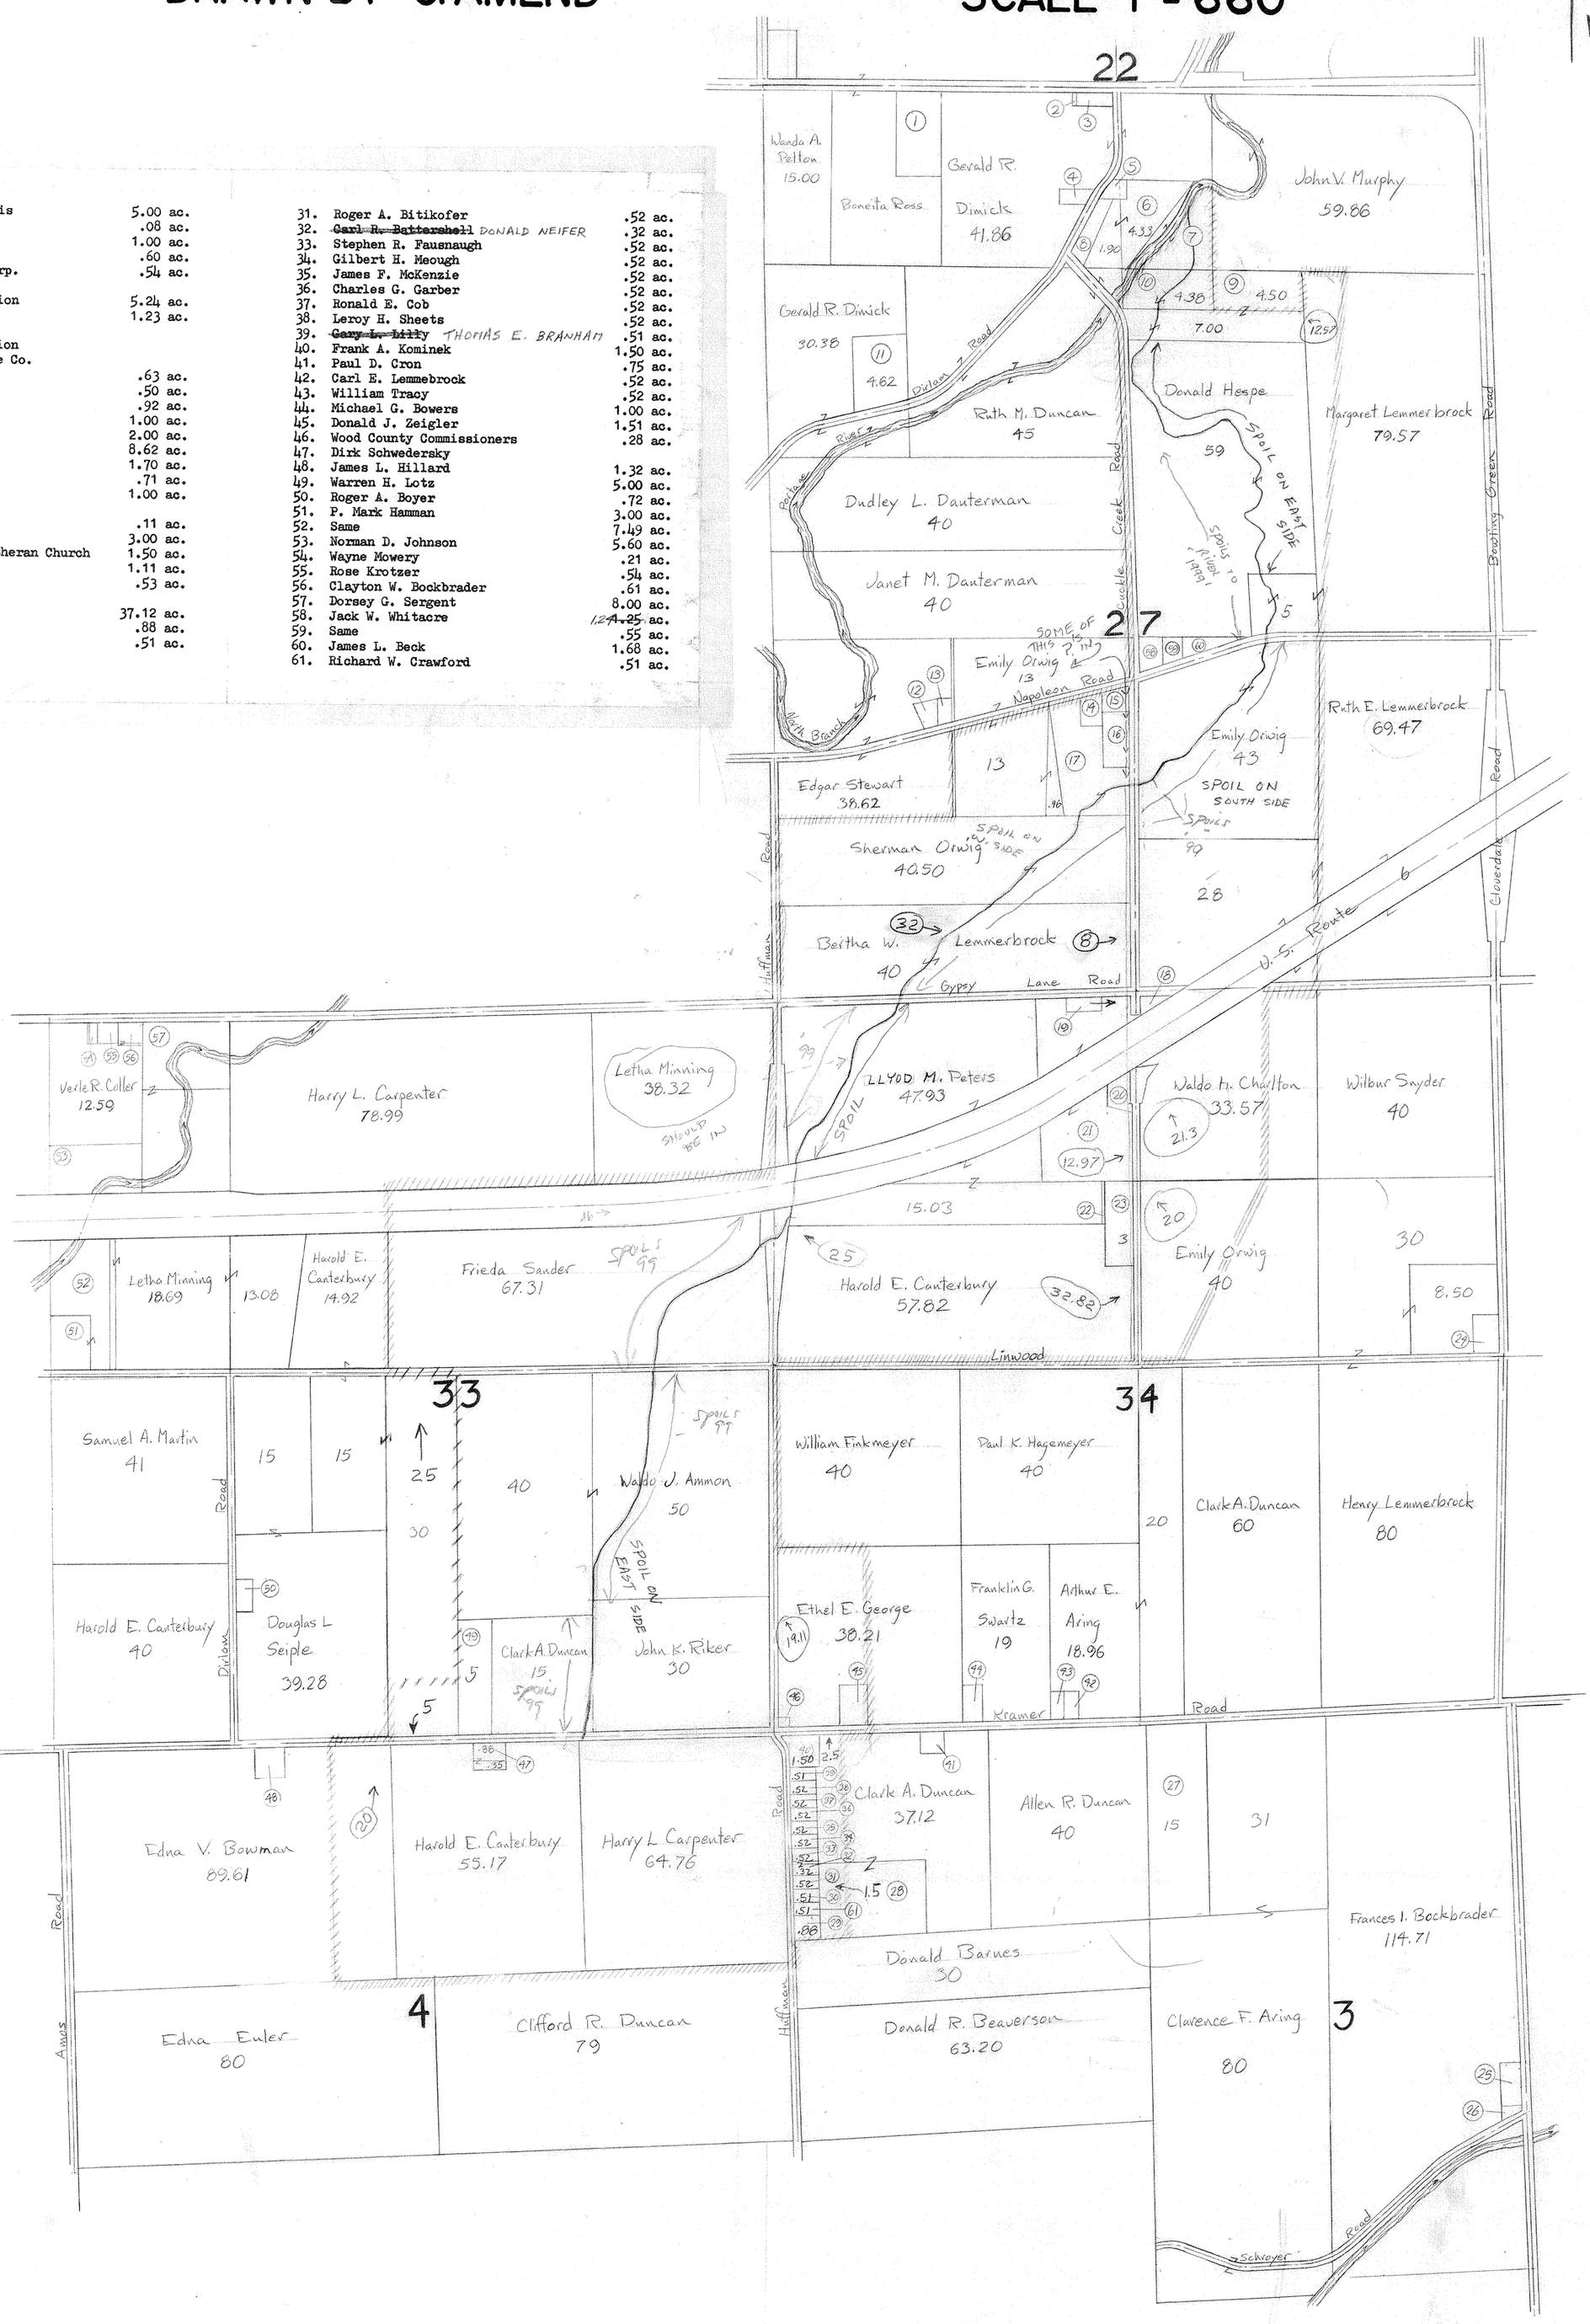
1.	Raymond H. Michaelis	5.00 ac.
2.	Donnan E. Marten	.08 ac.
3.	Same	1.00 ac.
4.	James M. Dimick	.60 ac.
5.	Wood Television Corp.	.54 ac.
6.	Same	
7.	Knowlton Construction	5.24 ac.
8.	Same	1.23 ac.
9.	John V. Murphy	
10.	Knowlton Construction	
11.	Ohio Bell Telephone Co.	
12.	Harold R. Austen	.63 ac.
13.	Jack R. Eckert	.50 ac.
14.	Lee I. Heverman	.92 ac.
15.	Gary N. Parritt	1.00 ac.
16.	George E. Perkins	2.00 ac.
17.	Shirley Heverman	8.62 ac.
18.	Kenneth L. Davis	1.70 ac.
19.	M. Lenore Eschedor	.71 ac.
20.	John Eschedor	1.00 ac.
21.	Mabel A. Edwards	
22.	Edgar L. West	.11 ac.
23.	Same	3.00 ac.
24.	Trustees German Lutheran Church	1.50 ac.
25.	Richard C. Kendall	1.11 ac.
26.	Same	.53 ac.
27.	Clarence F. Aring	
28.	Clark A. Duncan	37.12 ac.
29.	Mark L. Valentine	.88 ac.
30.	Dennis E. Harper	.51 ac.
31.	Roger A. Bitikofer	.52 ac.
32.	~~Carl R. Battershell~~ DONALD NEIFER	.32 ac.
33.	Stephen R. Fausnaugh	.52 ac.
34.	Gilbert H. Meough	.52 ac.
35.	James F. McKenzie	.52 ac.
36.	Charles G. Garber	.52 ac.
37.	Ronald E. Cob	.52 ac.
38.	Leroy H. Sheets	.52 ac.
39.	~~Gary L. Hilly~~ THOMAS E. BRANHAM	.51 ac.
40.	Frank A. Kominek	1.50 ac.
41.	Paul D. Cron	.75 ac.
42.	Carl E. Lemmebrock	.52 ac.
43.	William Tracy	.52 ac.
44.	Michael G. Bowers	1.00 ac.
45.	Donald J. Zeigler	1.51 ac.
46.	Wood County Commissioners	.28 ac.
47.	Dirk Schwedersky	
48.	James L. Hillard	1.32 ac.
49.	Warren H. Lotz	5.00 ac.
50.	Roger A. Boyer	.72 ac.
51.	P. Mark Hamman	3.00 ac.
52.	Same	7.49 ac.
53.	Norman D. Johnson	5.60 ac.
54.	Wayne Mowery	.21 ac.
55.	Rose Krotzer	.54 ac.
56.	Clayton W. Bockbrader	.61 ac.
57.	Dorsey G. Sergent	8.00 ac.
58.	Jack W. Whitacre	1.24 ~~4.25~~ ac.
59.	Same	.55 ac.
60.	James L. Beck	1.68 ac.
61.	Richard W. Crawford	.51 ac.